

ITEM	QTY	MATL	PART NO.	DESCRIPTION
1	1	CIS	D-502070	MOTOR STEAM 60-14 TORUS DISC
2	1	CIS	D-502061	60-14 T.D. ROTOR JOURNAL DRIVE
3	1	CIS	D-502062	60-14 T.D. ROTOR JOURNAL TAIL
4	1	I	D-50216	PLATE PLACEMENT
5	2	NUT/N/A		TOPPING NUT 350
6	156	CIS		1/8-8 UNI-LAB BOLT X 3/4"
7	152	CIS		7/16" LOCK WASHER
8	164	SYS		LOCK WIRE

61831

~~61831~~  
61831  
~~61831~~

CERTIFIED DRAWING	
BEPLEX CORP.	
DATE	1/16/74 PER
FOR Enclosed P/L 1/2	

A Project: Carver Greenfield  
Water Dehydration & EMS  
Contract No.: 1  
Subcontractor Date: 1/16/74  
Foster Wheeler  
Brinderson Corporation  
Belex Corporation  
86000510  
60-14 Torus Disc

B Owner:  
Engineer:  
Contractor:  
Sub Contractor:  
Sub Contractor No.:  
Supplier's Purchase Agreement No.:  
Manufacturer's Name:  
Contract Drawing Reference:  
Applicable Specifications:  
Description of location:  
within the facility being  
constructed, where:  
Installation is intended:

C To Follow:  
Harsco Boiler & Manufacturing Co.  
170-11, 1M-144, 1M-151, 1M-152  
11K  
Dimensions: Column  
X... x Y...  
A1-SPE  
102-42

REV DATE ECR NO. DESCRIPTION I CR 10KA


This drawing is the property of BEX CORPORATION  
and is furnished to you in confidence. Its reproduction  
and/or disclosure in whole or in part by the person  
to whom it is furnished is prohibited without the written  
consent of BEX CORPORATION.

TOLERANCES	ISO 28	METHOD	TITLE: 60-14 TORUS DISC
UNLESS OTHERWISE SPECIFIED			PRINTED DRAWING AS THIS
INCHES	MM		1/2" - 1/4" TORUS DISC
FRACTIONS	MM		1/2" - 1/4" TORUS DISC
DECIMALS	MM	MACH FIN	1/2" - 1/4" TORUS DISC
ANGLES	DEGREES	UNIVERSAL	1/2" - 1/4" TORUS DISC
CLIPS	STAINLESS	TYPE	1/2" - 1/4" TORUS DISC

bepex corporation

ITEM	QTY	MAT'L	PART NO.	DESCRIPTION
1	1		B-503282	STEAM INLET MANIFOLD DETAIL
2	1		B-503283	SUPPORT CHANNEL DETAIL
3	2		A-503308	STEAM OUTLET HEADER DETAIL
4	3		A-503309	STEAM OUTLET HEADER DETAIL
5	1		A503288	STEAM OUTLET HEADER SUPPORT ANGLE
6				
7	1		B-503512	WELDING FIXTURE
8	20	M/S		1/8"UNC U-BOLT FOR 1/2" PIPE (COMPLETE) HD/MLD
9	10	M/S.		3/8"UNC U-BOLT FOR 1" PIPE COMPLETE w/ HEX NUT
10	10		GASKET	1/2"-150# (.115 THK.) FLEXITE SUPER NON ASB.
				304 SS. WINDING & C.S. OUTER RING
11	40	SA-193- BT		1/2"UNC HEX BOLT X 2" LG.
13	40	SA-194- 2H		1/2" UNC HEX NUT.
14	5	SA-105		1/2" ~150# R.F. S.W. FLG.
15	A/R	SA-106- D SMLS		1/2" SCH 40 PIPE
16	13	SA-105		1/2" 300# SOCKET WELD 90° ELBOW
17	6	SA-105		1/2" 300# SOCKET WELD 45° ELBOW
18	5	FORGED	STEEL	1/2" GLOBE VALVE SOCKET WELD W/ NON ASBESTOS PACKING TO SEE 551 STEAM ~ VOGT # SW-12141
A	19	20	STEEL	SWAGELOK "S-B10-1-B" MALE COU.N.
A	20	20	STEEL	SWAGELOK "S-B10-7-B" FEMALE COU.N.
A	21	SOFT	STEEL	TUBE 1/2" O.D. X .065 WALL TUBE SAE J-524 SOFT ANNEALED


61831

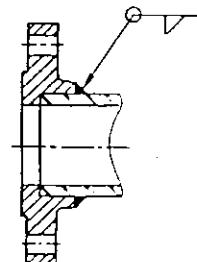

DETAIL A  
TYP FOR ALL SOCKET WELD FLANGES


NOTE:

- 1. HYDRO TEST AT 225 PSIG AFTER WELDING.
- 2. ALL WELDING TO BE DONE USING ASME CODE
- WELD PROCEDURES.

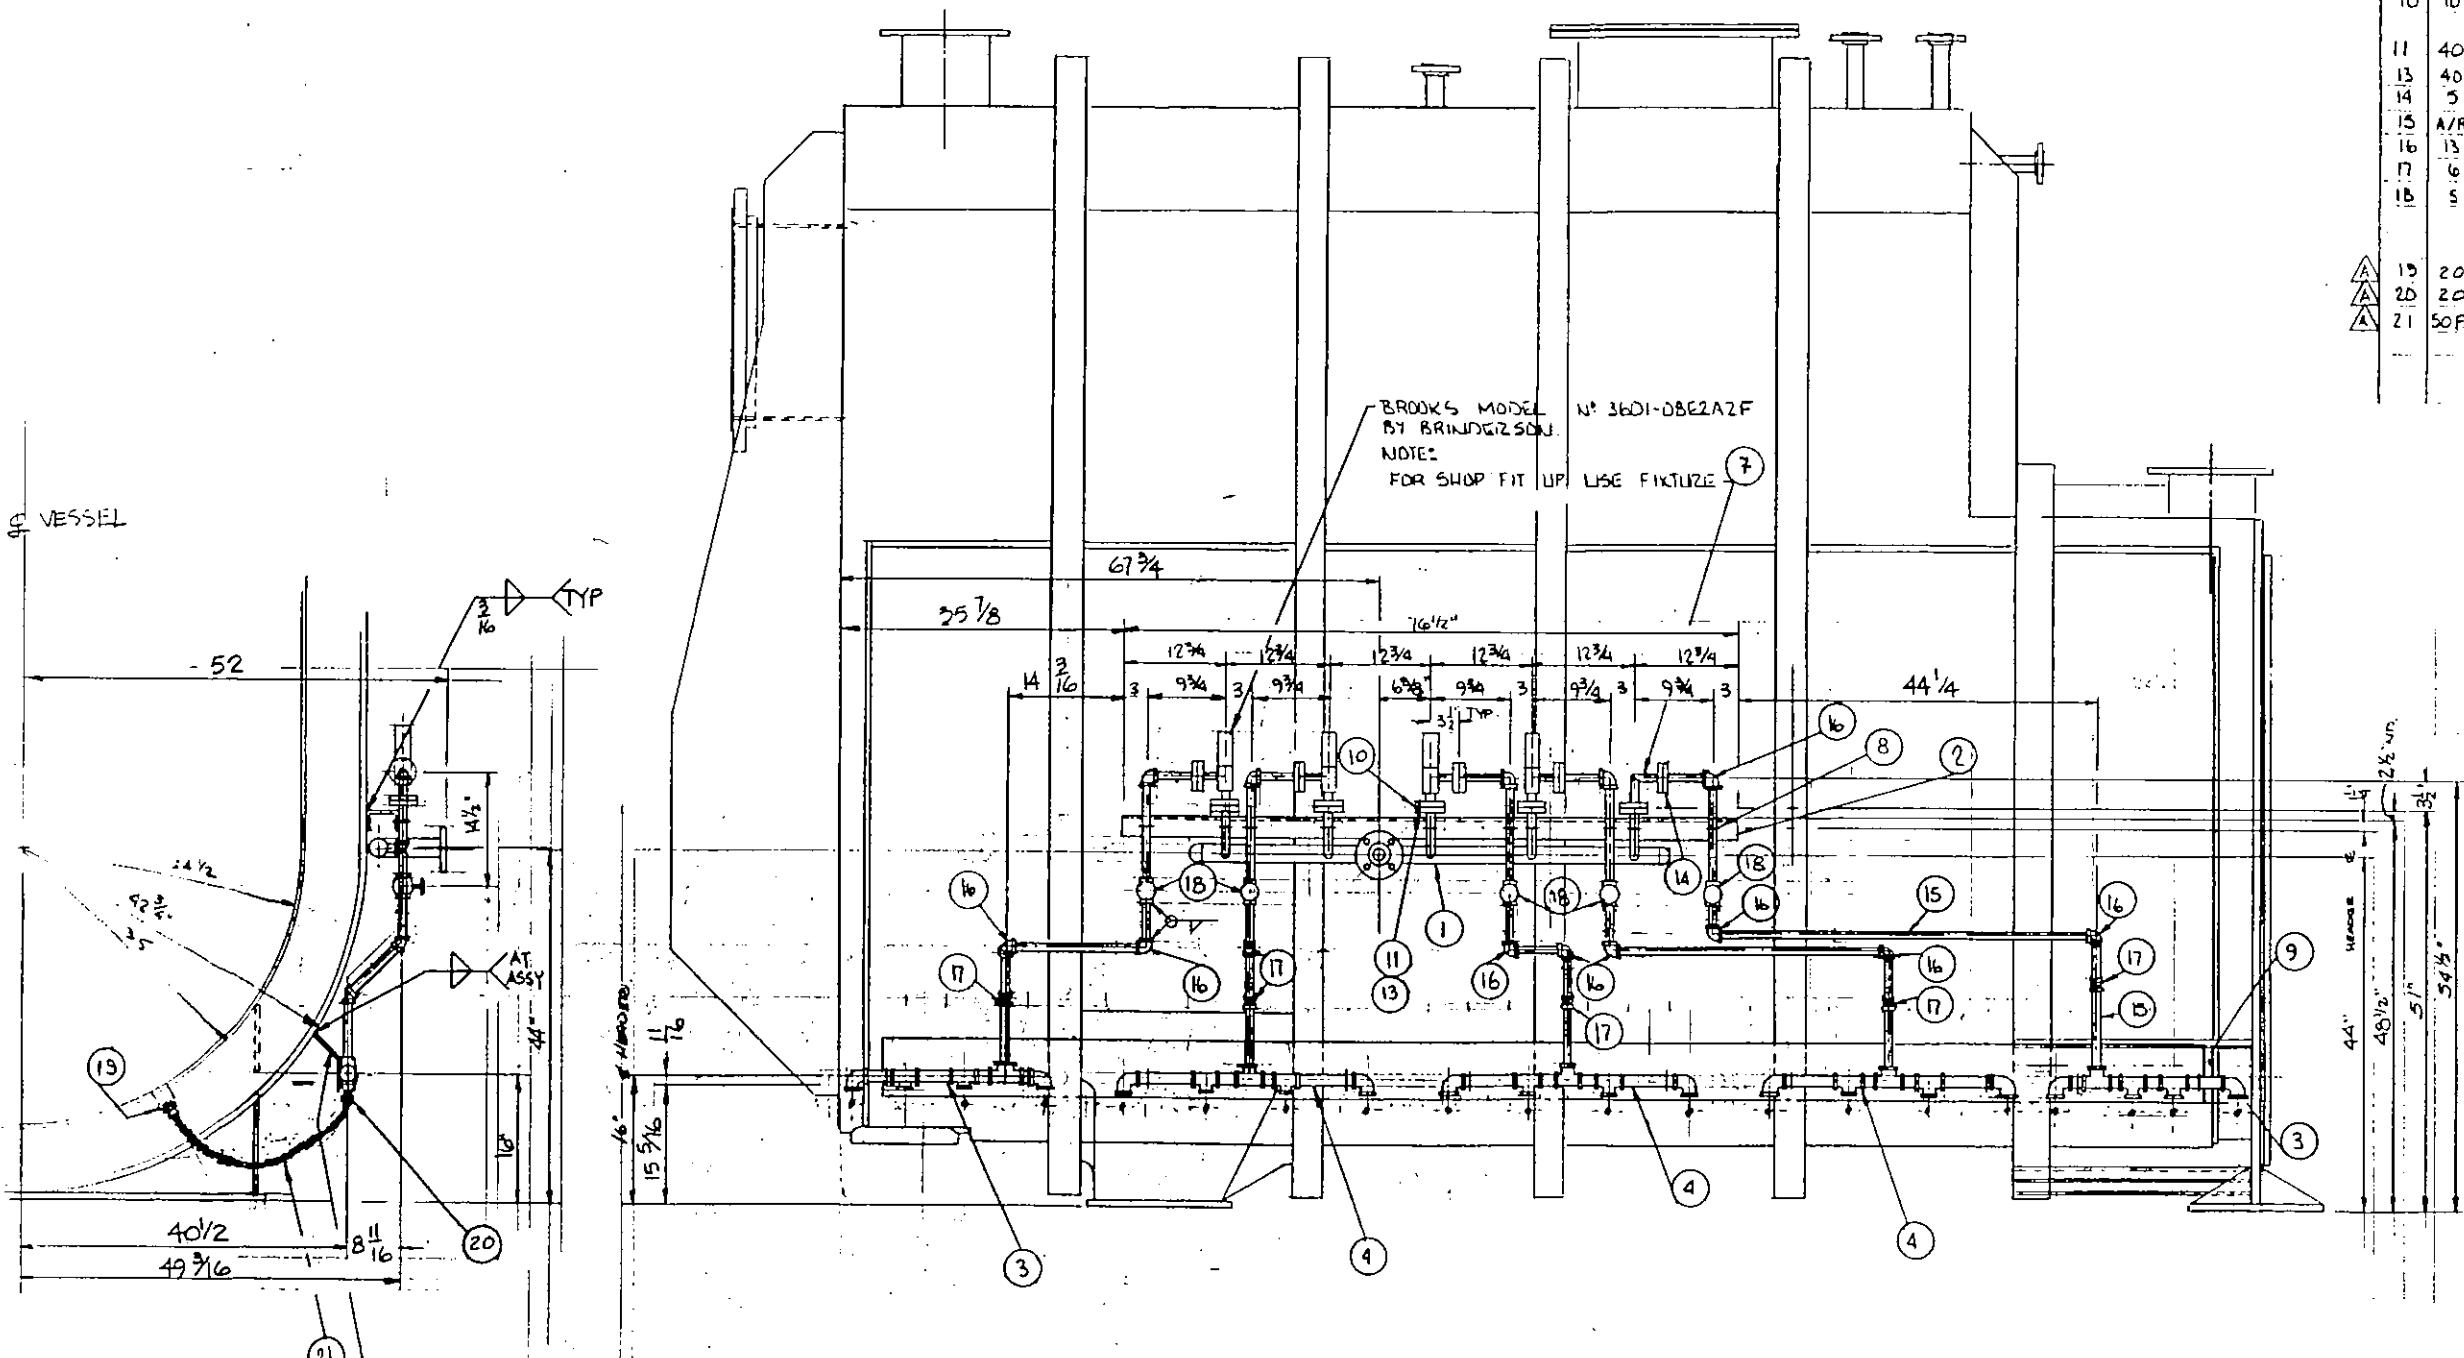

A	1/31/88		ITEMS #15, 20 & 22 WERE HOSE BARBS & CLAMPS ITEM # 21 WAS RUBBER HOSE	Jay	
REV.	DATE	ECN. NO.	DESCRIPTION	DR	CHK
THIS DRAWING IS THE PROPERTY OF BEPEX CORPORATION AND IS TRANSMITTED IN CONFIDENCE. THE REPRODUCTION, USE, OR DISCLOSURE, IN WHOLE OR IN PART, OF THE DESIGN CONTAINED HEREIN IS PROHIBITED WITHOUT THE WRITTEN CONSENT OF BEPEX CORPORATION.					
TOLERANCES: UNLESS OTHERWISE SPECIFIED		ISO 128 METHOD A	TITLE 1K-1L-1M - DR-1D1 STEM SPARE MANIFOLD ASSY. TURB DISC		
FRACTIONS	5		APP	SCALE 1/16"	REV
DECIMALS	XX.5	MACH. FIN. UNLESS NOTED	CHK	5.5-86	DRAWING NO.
ANGLES	XXX.1		DR	D.R.TARR B.B.P.	
HOLES	5	✓	NEXT ASSY	D503295	
USED ON	+ .010. - .006			A	
PART NO.	SIM TO		ORIG. JOB NO.	SHEET OF	

\* Box 4 SHIP WITH UN

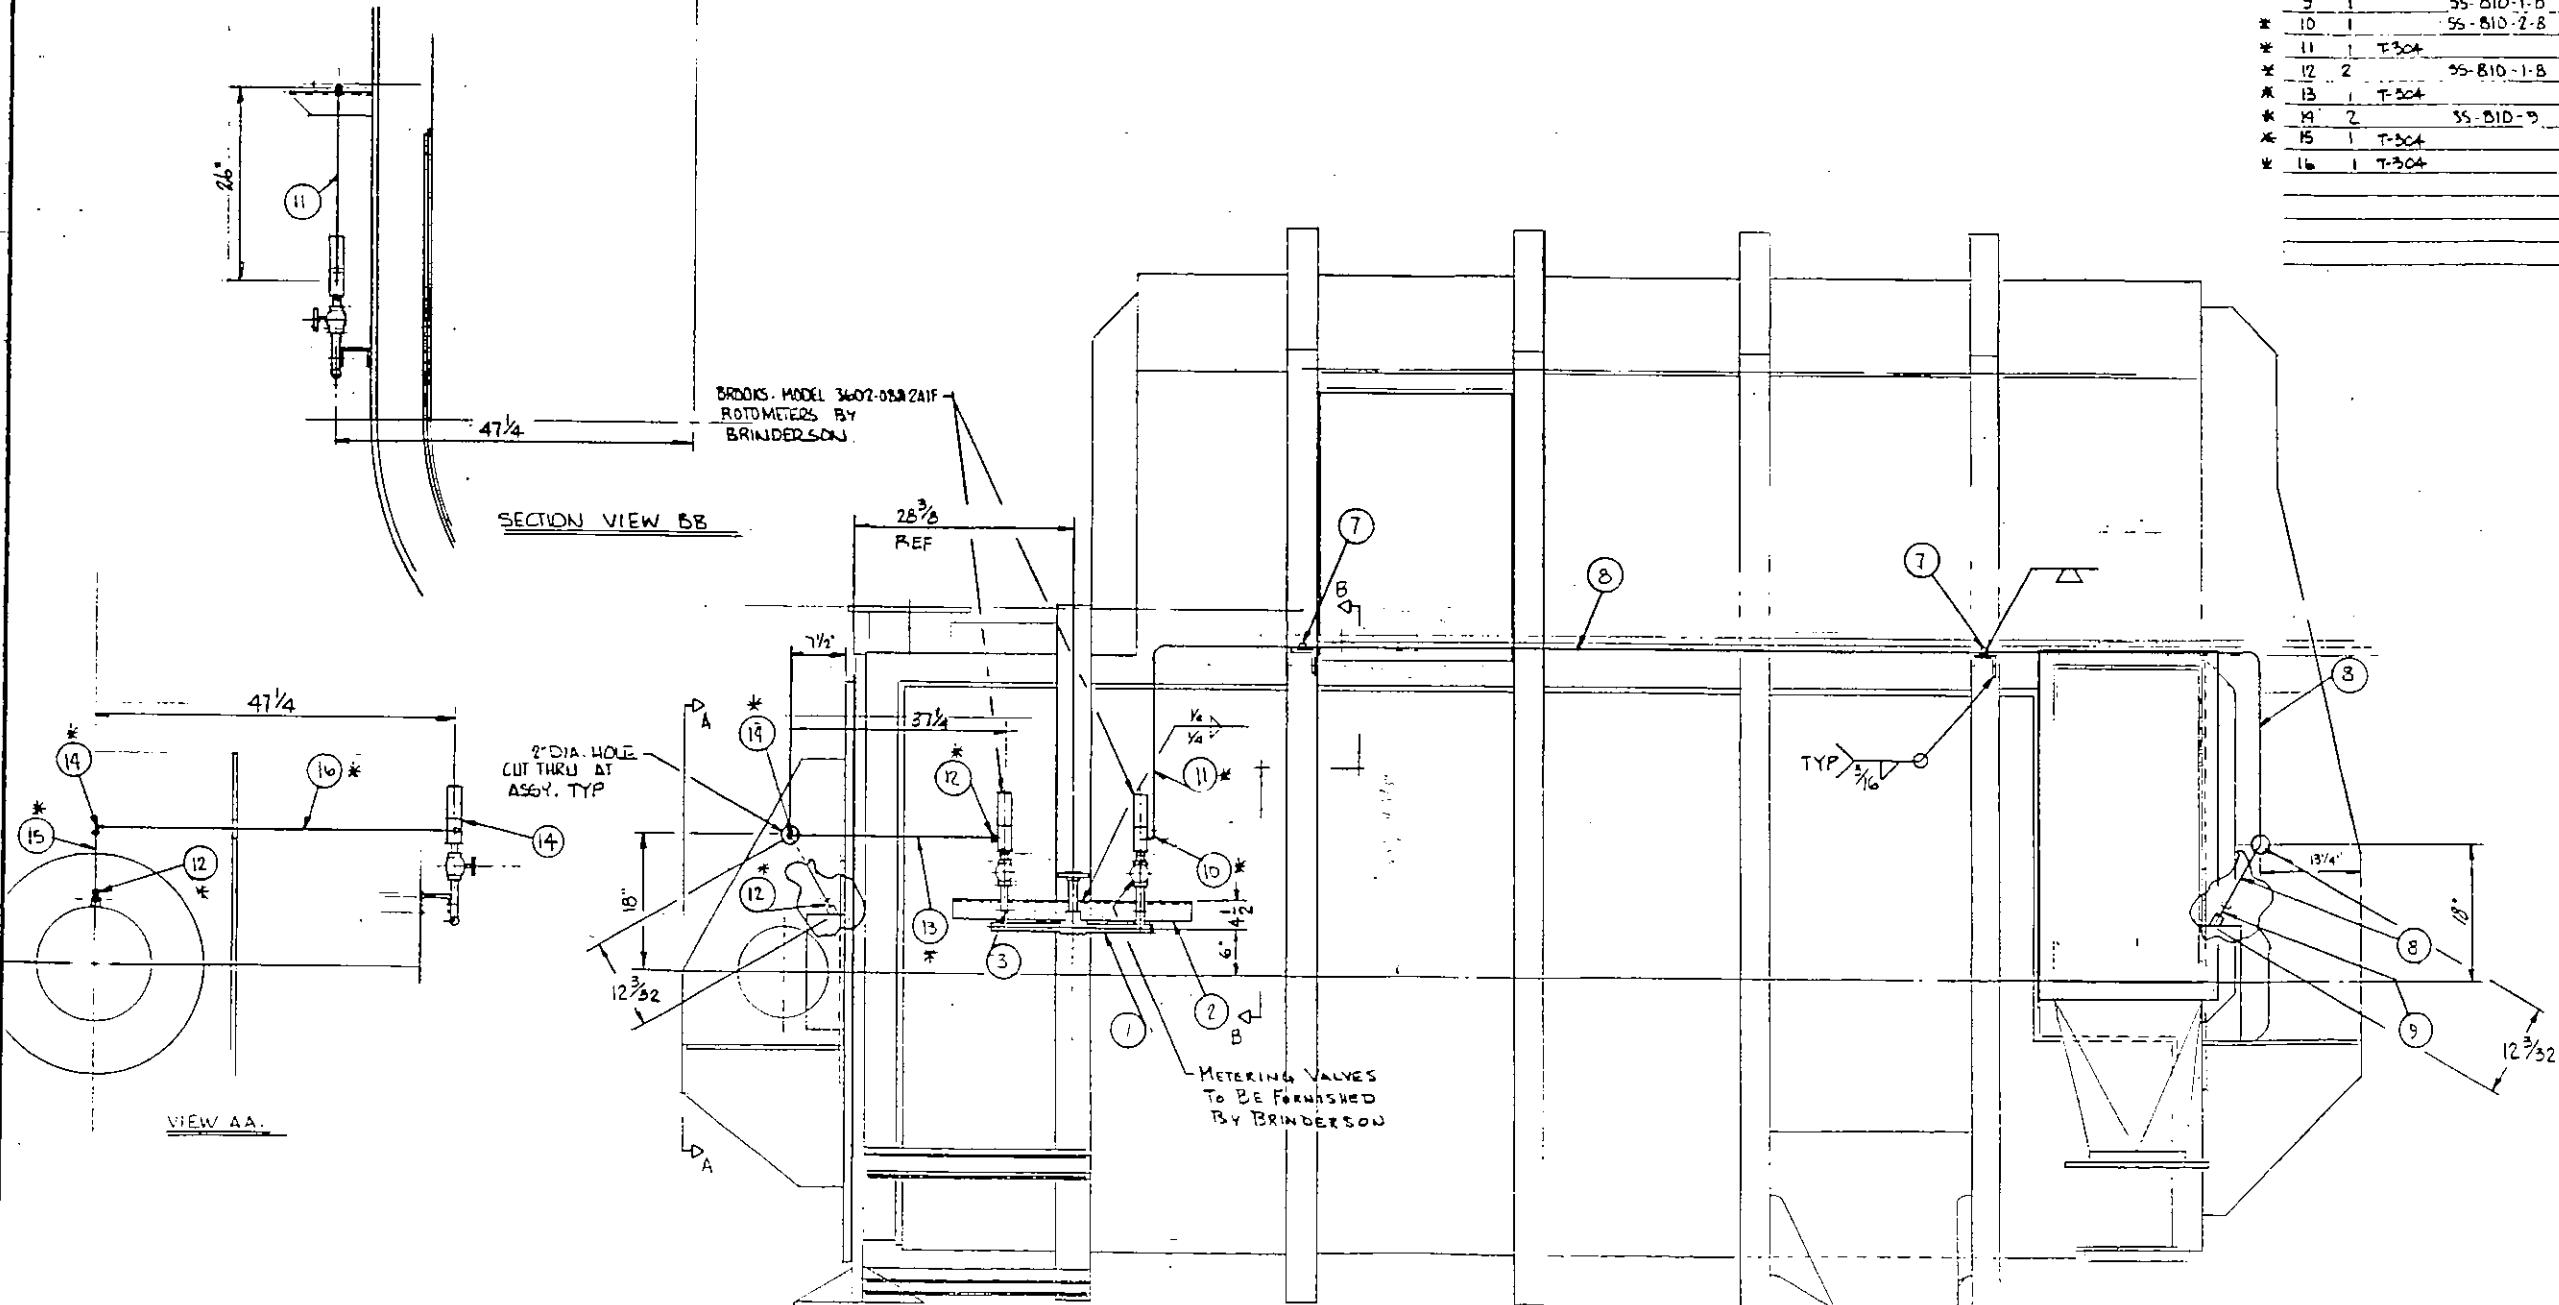

61831

CERTIFIED DRAWING  
BEPEX CORP.  
DATE 12/14/66 PER Ed  
FOR Engineering Dept Pg 622

REV.	DATE	ECN. NO.	DESCRIPTION	DR	ICN
THIS DRAWING IS THE PROPERTY OF BEPEX CORPORATION AND IS TRANSMITTED IN CONFIDENCE. THE REPRODUCTION USE OR DISCLOSURE, IN WHOLE OR IN PART, OF THE DESIGN CONTAINED HEREIN IS PROHIBITED WITHOUT THE WRITTEN CONSENT OF BEPEX CORPORATION.					
TOLERANCES UNLESS OTHERWISE SPECIFIED		ISO 128 METHOD A 	TITLE N° 2 SEAL PURGE MANIFOLD ASSY. 100-14. TORUS DISC		
FRACTIONS 1/8		MACH. FIN UNLESS NOTED	APP I SCALE 1" = 1"		
DECIMALS 1.000			CHK 1/1 M. & J. SET DRAWING NO. IREV.		
ANGLES 2			DR. DE TAKK FILED 1/1		
HOLES .070 - .005		✓	EXT. REV. D 6/20/92		
INCHES					

