



TYP. TRAY RINGS & DOWNCOMER BARS (EXCEPT) (NO SCALE)

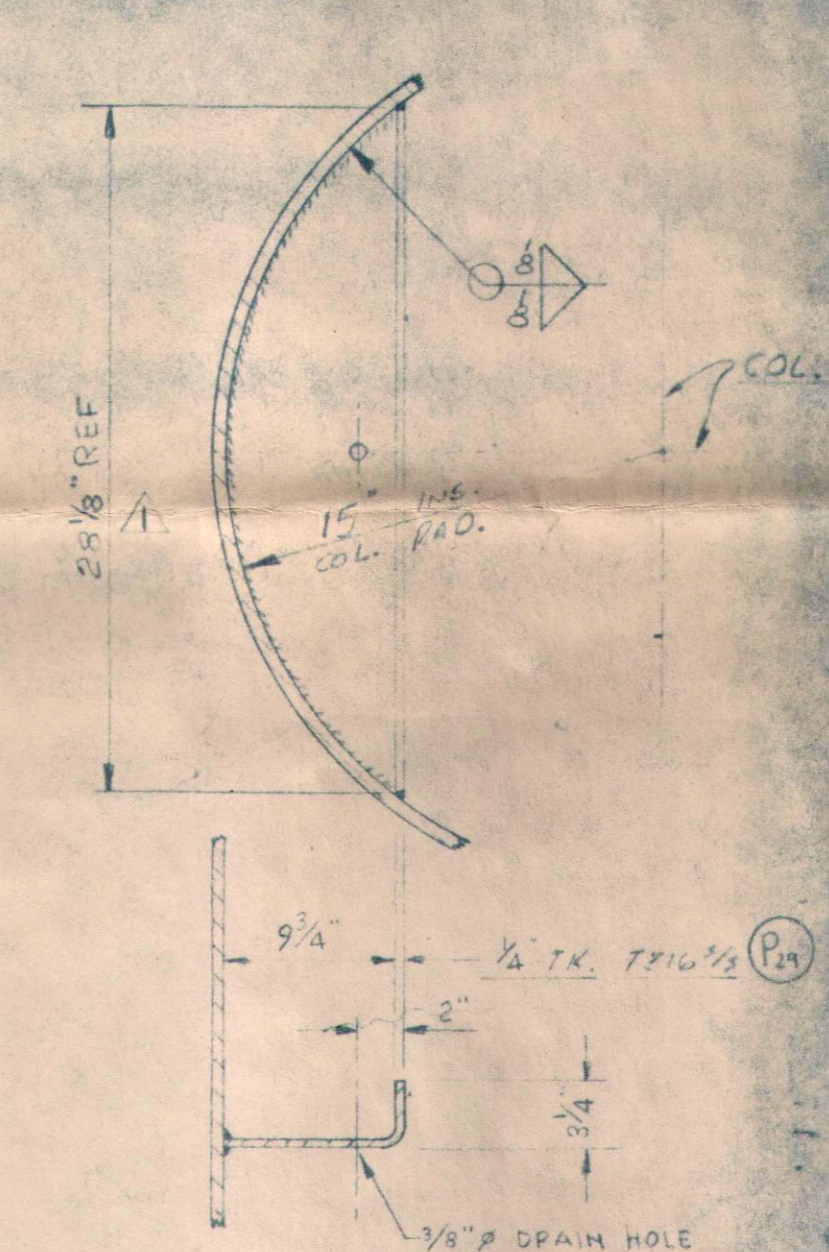

SEAL PAN BELOW TRAY (NO SCALE)

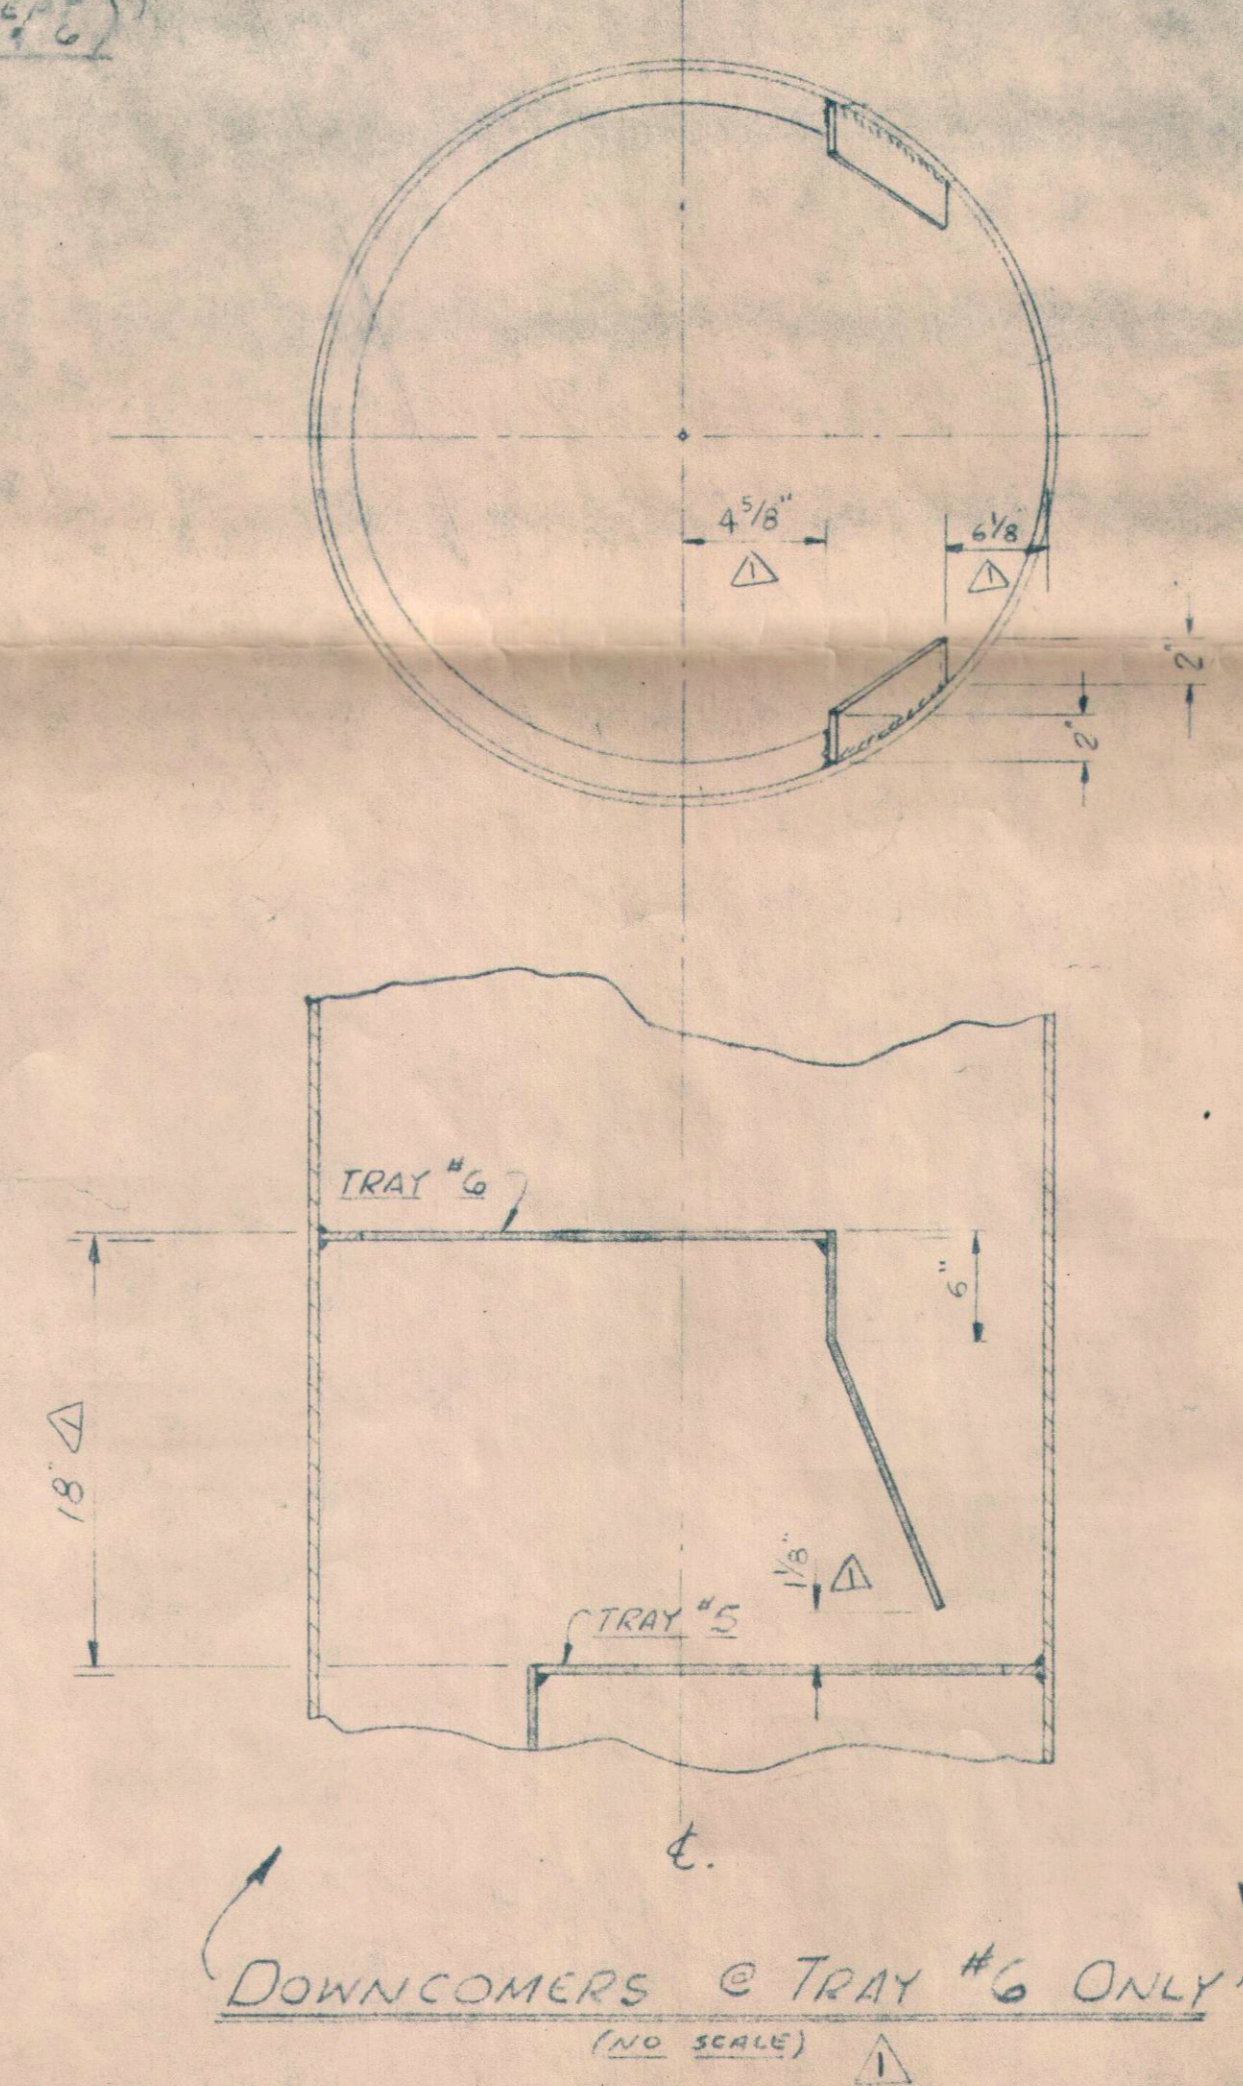

DOWNCOMERS @ TRAY #6 ONLY (NO SCALE)

BASE LINE. ALL TAN. DIMS. FROM BOT. TAN. LINE SEE DWG. CF-D-58527-R

COLUMN ELEVATION (NO SCALE)

APPROVED FOR LAYOUT ONLY  
 CATALYTIC CONSTRUCTION CO.  
 Date: 6-2-70  
 Signed: [Signature]  
 Engineering Department  
 All details and dimensions are the responsibility of the vendor. Proceed with fabrication. The approval does not constitute a warranty of the subcontractor to meet specifications and conditions of the subcontract or purchase order.

RYAN W.O. #58527

WORK THIS DWG. WITH CF-D-58527-B.

VENDOR PRINT NO 33020-0501-18-3R3

PRINT ISSUED			
RYAN INDUSTRIES INCORPORATED			
TAY & DAWIT DETAILS FOR ITEM T-91 FOR CATALYTIC CONSTRUCTION CO. PHILADELPHIA, PENNSYLVANIA			
ADD VENDOR PRINT NO	REVISION	DATE	BY
REVISOR AS MARKED BY PER		4-20-70	PF
CCC APPROVAL DATED	16 MAR 70		
NO.	REVISION	DATE	BY
DRAWN BY: [Signature]			
CHECKED BY: [Signature]			
APPROVED BY: [Signature]			
CUST. P.O. 33020-0501-18			