

GENERAL TOLERANCES		Nominal measure									
Welded constructions (DIN 6910)	Precision class	>0,3 <-0,3		>0,6 <-0,6		>1,2 <-1,2		>2,5 <-2,5		>5 <-5	
		A	B	A	B	A	B	A	B	A	B
Machining (DIN 6910)	Tolerance class	±0,1	±0,2	±0,3	±0,5	±1,2	±2	±3	±4	±5	±6
		Medium									

<b>URS</b>	Project No.	30122	Date Received	4/28/2011
	Project Name	Clearfalls		
	Equipment No.	5111	Co. Print No.	33
	Equipment Tag(s)			


✓ NC-R = No Comments - Released for Fabrication  
 ✓ WC-R = With Comments - Released for Fabrication with Comments Incorporated  
 ✓ R = Rejected - Not Released for Fabrication  
 ✗ NR = Engineer's Review Not Required - Considered for Information Only  
 ✗ V = Void  
 ✗ Record Document Submittal Required

Note: Status (WC-R) and (R) require re-submission of affected documents with comments addressed. Status (NC-R) requires re-submission only if designated as "Record Document Submittal Required".  
 Date: 5/16/11  
 Signature: [Signature]

Item No	Material	Lenght mm	Widht mm	Height mm	Motor HP	Weight kg
T 1402	SA 240 304	2000	2955	1640	-	1283 kg
S1401 A-D	SA 240 304	2225	180	180	1 HP	176 kg/pc
S 1404	SA 240 304	2892	250	250	5 HP	260 kg
Total						2248 kg

Auslegungs und Betriebsdaten/Construction and working data			
Medium	Biomass		
Inhalt/Volum	Total	1300 l	
	Operating	600 l	
Zul. Betriebsüberdruck/Working pressure min/max	+0,2/-0,2	bar	
Zul. Betriebstemperatur/Working temp. min/max	100	°C	
Berechnungsüberdruck/Design pressure min/max	+0,2/-0,2	bar	
Berechnungstemp./Design temp. min/max	100	°C	
Probeldruck/Test pressure	-	bar	
Korrosionszuschlag/Corrosion allow	0		
Abnahme/Inspected by	-		
Fabr.-Nr./Serial-no.	2225/01		
Baujahr/Year of manufacture	2011		
Korrosionsschutz/Protection against corrosion	pickled and passivated		
Isolierung/Isolation	no		
Leergewicht/Weight empty	2248 kg	Betriebsgewicht/Operation weight	2400 kg
		Gefüllt/Gewicht/Full weight	2600kg
Hauptwerkstoffe/Main material	SA 240 T 304		

Stk	Stk.	Dim.	Norm	Beschreibung	Rohranschluss
Mark	Piece	DN PN	ANSI/DIN	Description	Tubedimension
AI/2	2	12" CL150	B16.5	Inlet	323,9 x 4
B	1	250	-	Outlet	273 x 4
C	1	250	-	Inspektion hole	273 x 4
D	1	600x600	-	Manhole	600x600
E1-4	4	3/4" NPT	-	Levelcontro (plugged)	-
F	1	3"	CL150 B16.5	Vent/blinded	88,9 x 4
G1-3	3	1" NPT	-	Prestrain in (plugged)	-
H1-2	2	1" NPT	-	Drain (plugged)	-
I1-2	2	1" NPT	-	Drain (plugged)	-
K1	1	1311 x 583	-	Cover Dischargescrew Tail End	Blindcover
K2	1	919 x 206	-	Cover Drive End	Blindcover

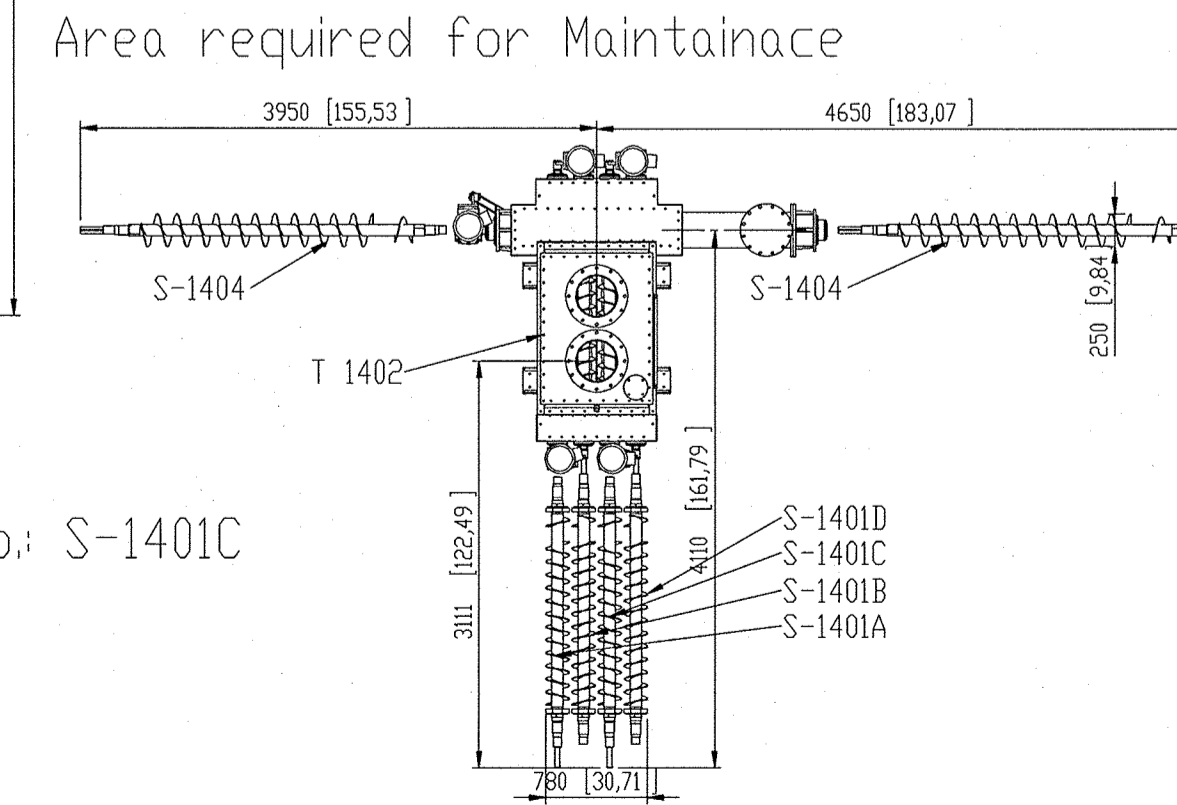


**SURGE HOPPER**  
**Equip. No.: T1402**  
**CONFORMS TO ISO STANDARDS**

Customer	APC	Basic Material Name	Basic Material Standard	Net Weight	kg
Customer	Customer Drawing No.	306 / 2396 L	SA 240	1283	
Product Type	Product Code	Description Line 1	Desig	Date	
Scale	Scale	Description Line 2	Desig	Date	
Revision	Revision	Description Line 3	Desig	Date	
Approval			Approval	Date	
Approval		Approval	Approval	Date	
SAP Mat. No./Variant	Reference Drawing			Rev.	Rev.
SAP Mat. No./Element	Reference Drawing			Rev.	Rev.
				701876977	E 1 A