


SECTION A-A

SECTION B-B

SECTION C-C

SECTION D-D

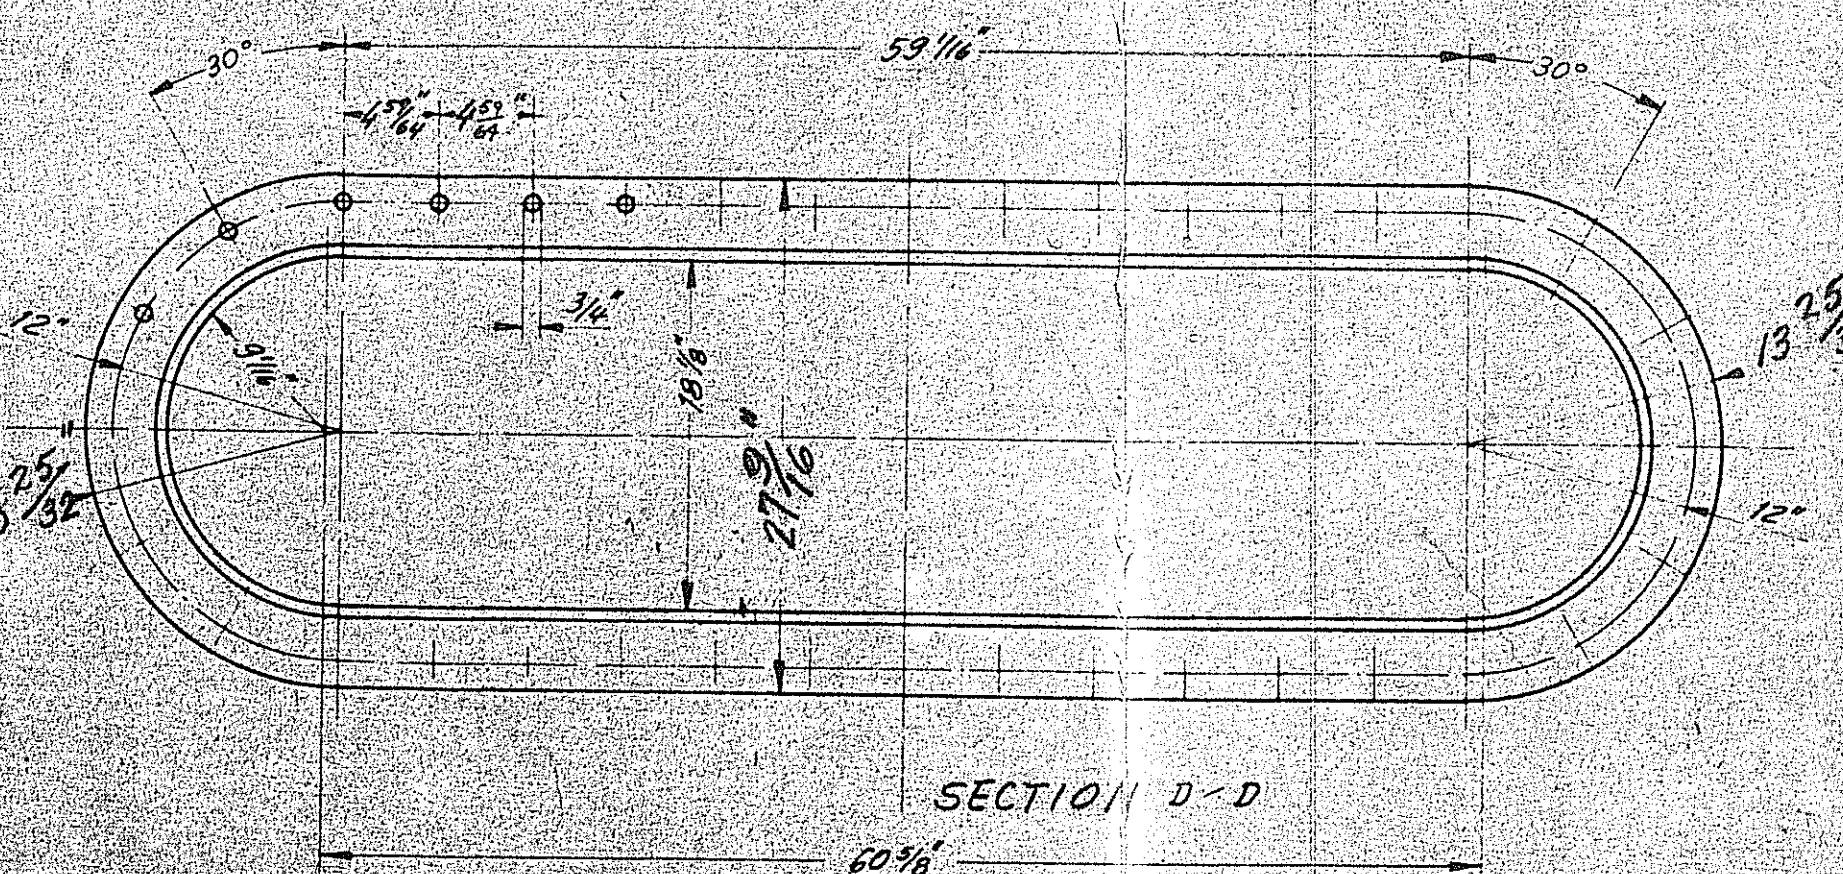

VENDOR PRINT FILE 4299 DATE 12-7-72
 SHEET 3 EQUIPMENT NOS.
 PROJECT & ACCOUNT NOS. 026035
 PURCHASE ORDER NO. 336-026-35279
 PLANT HANOVER
 REVIEWED - DRAFTING DESIGN
 APPROVED ENGINEER *A. E. Miller*

BASE FOR LEFT HAND ARRANGEMENT AS PICTURED. RIGHT HAND OPPOSITE.

AM	Aut. Becht.	Kommt v.	Tag	Name	AM	Aut. Becht.	Kommt v.	Tag	Name	AM	Aut. Becht.	Kommt v.	Tag	Name	
Maßstab		1972	Tag	Name	NB										
Fertiggewicht		1:10	gez.	G.F.	Hank										
Werkstoff		Benennung				Type		Modell-Nr.		Zuteilungs-Nr.		Ersatz für		Ersetzt durch	
Werkstoff Nr.		VIBRATION BASE FOR U-62 MILL						M-C2790/1a							
Paßmaß		Größtmaß		Kleinmaß											

#104470 / 104471