

DRESSER-RAND

WELLSVILLE OPERATIONS
37 COATS ST.
WELLSVILLE, NY 14895-0592

D-R DOCUMENT #: 33306-05
DOCUMENT TITLE: Steam Turbine Performance Curves (NORMAL CASE)
CLIENT DOCUMENT #: _____

INCLUDE - MINIMUM & MAX. Extradiam
CASES PER DATA SHEET

REVISION HISTORY:

Rev.	Date Issued	Description	Issued By
0	10/17/08	Initial Issue	JMIM

Index of Attached Documents:

Document #	Description

Dresser-Rand Reference Information:

D-R Contract Number: C-33306
D-R Unit Serial Number: D6397

Client Title Block:


Project Name: Tesoro LAR COGEN & Boiler Replacement
Client Name: Fluor
Client PO #: A4AN-4-0302-01/A4AN100196
Item #: 1ST-TRB-0100
End User: Tesoro - Los Angeles Refinery
End User Location: Wilmington, CA

DW - INFORMATION W/COMMENTS **FLUOR**

Receipt acknowledged. Notification of receipt of data does not constitute acceptance nor relieve Contractor/Seller of any liability. Acceptance is accomplished under the terms of the Contract/Purchase Order.

A4AN-4-0302-01-00018-1
TAGN NO.: T-0522

Number of Pages (Including Cover Page): 7

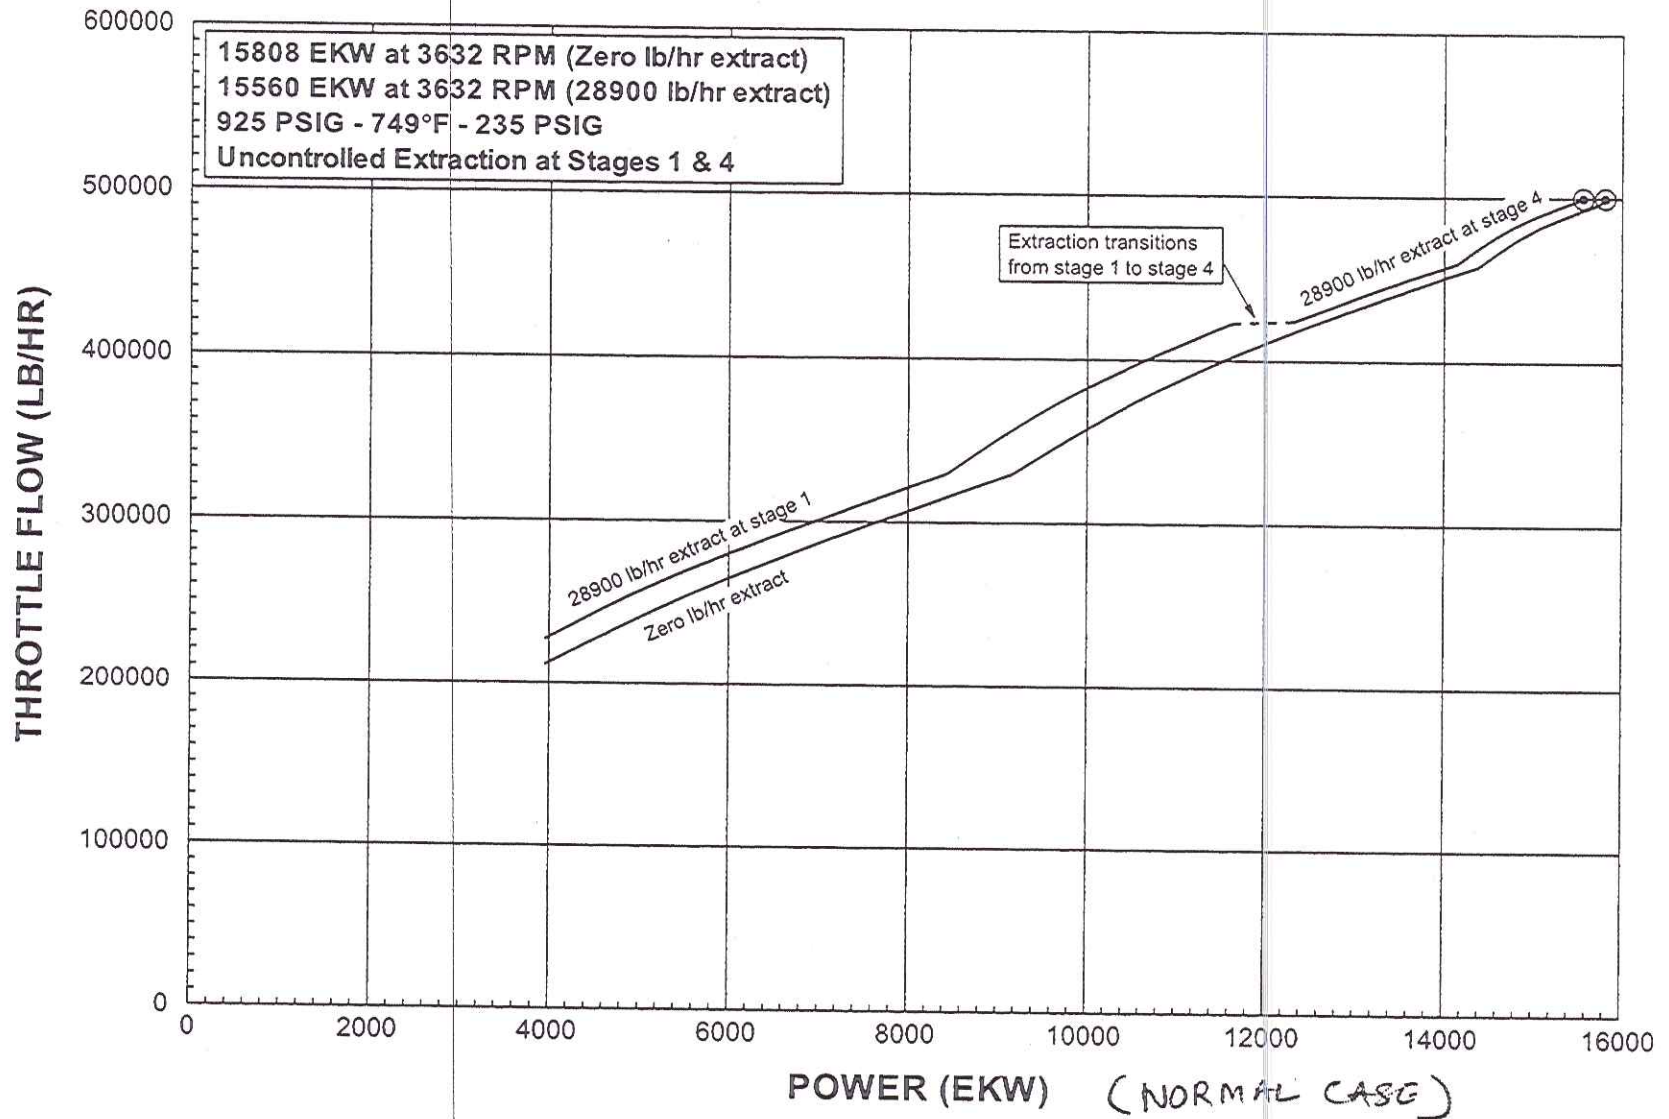


Drawn By: ets
 Jul 31 2008

DRESSER-RAND Wellsville Operations
 Wellsville, NY 14895 USA

C-33306-1

C33306-1.lay

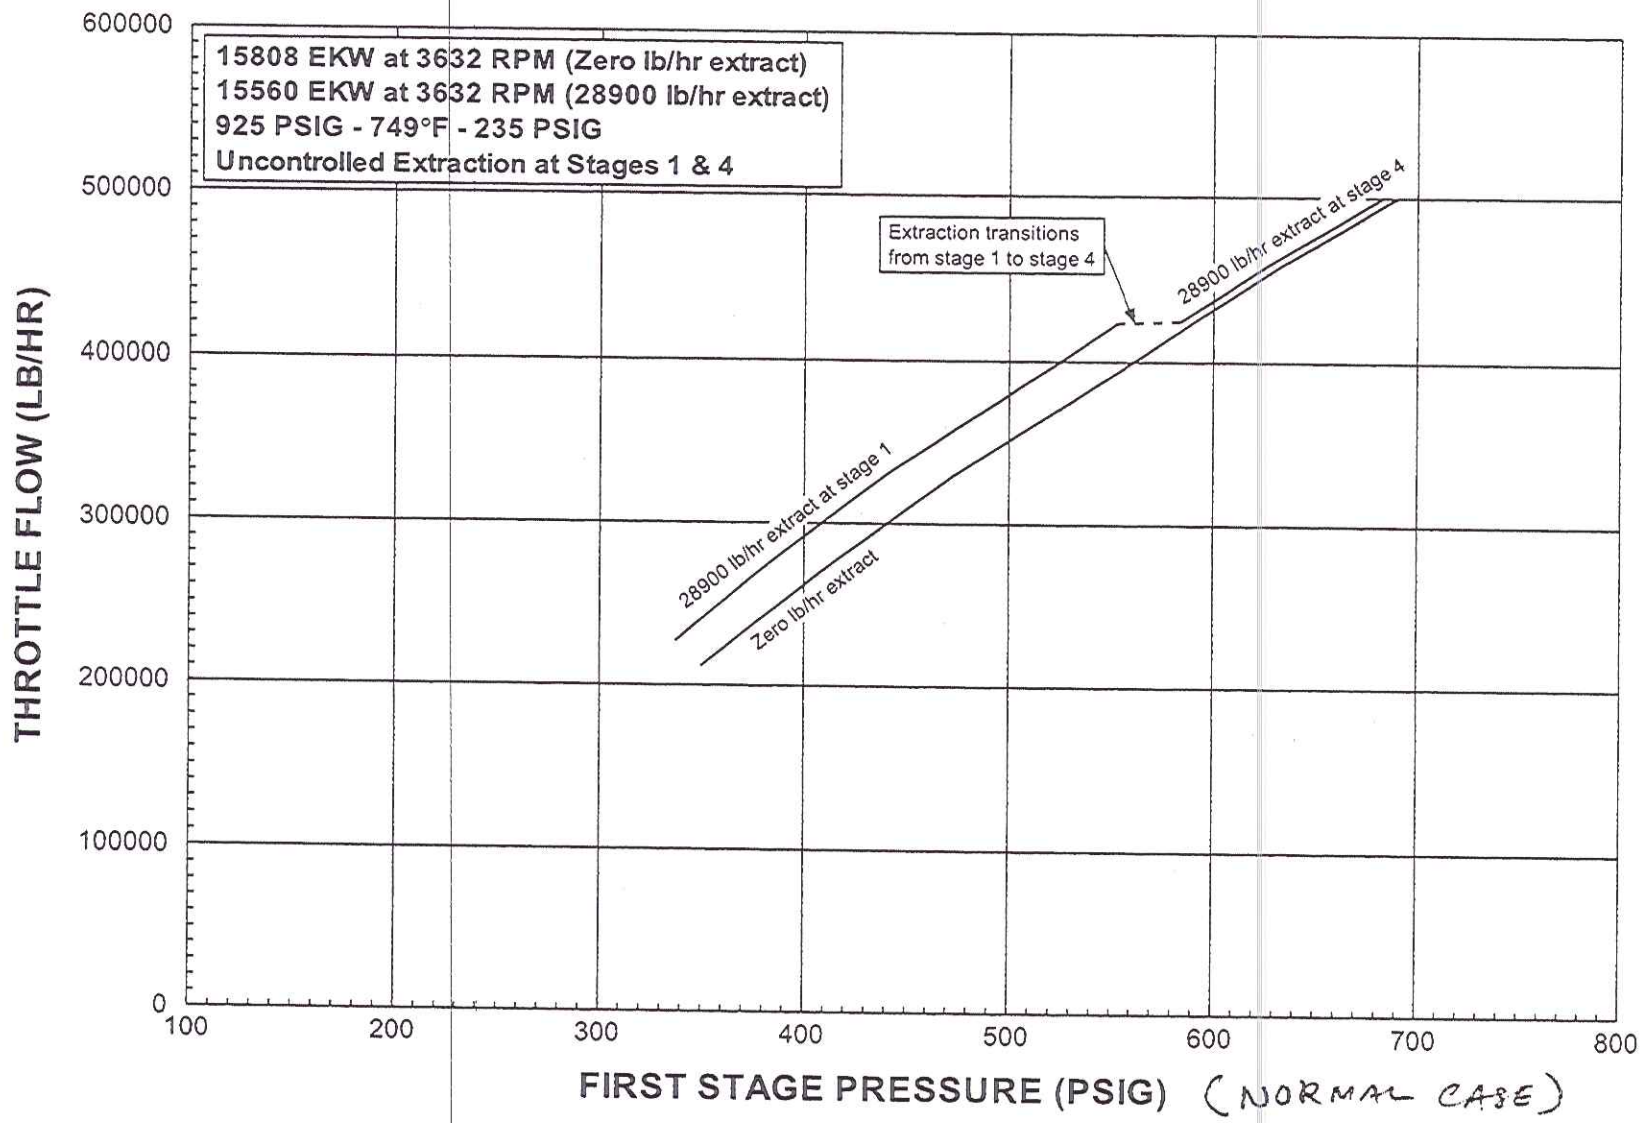


Drawn By: ets
 Jul 31 2008

DRESSER-RAND Wellsville Operations
 Wellsville, NY 14895 USA

C-33306-2

C33306-2.lay

CORRECTION FACTOR (CF)

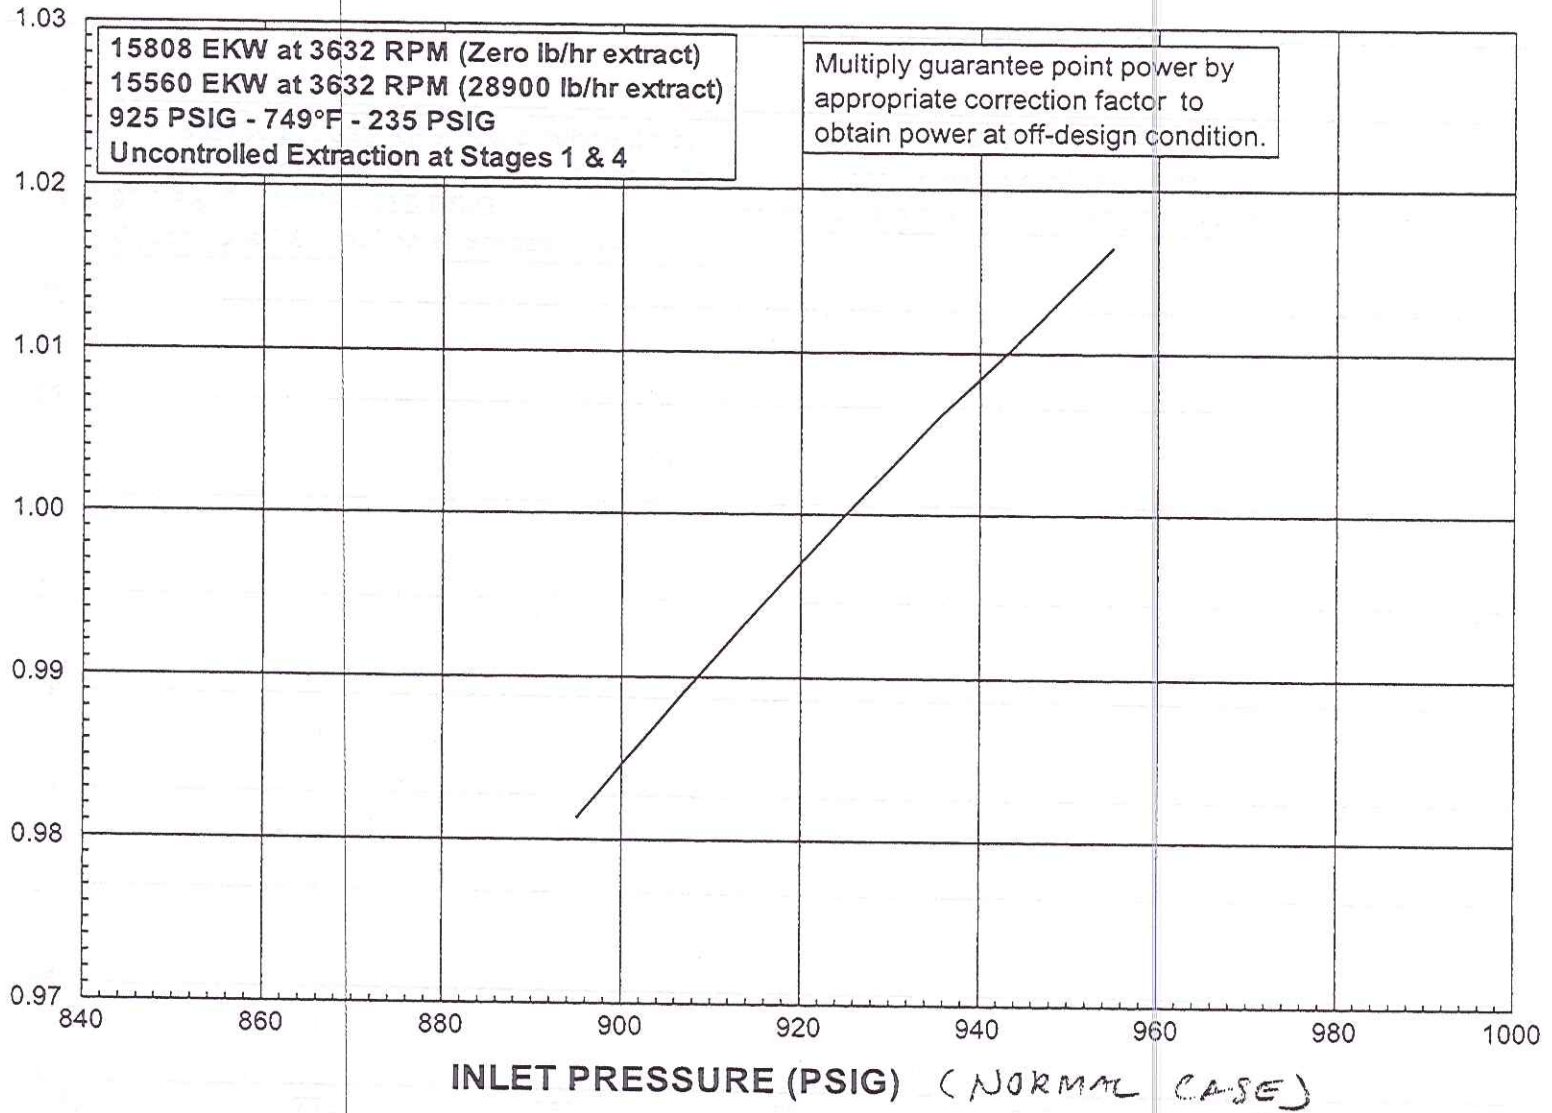


Drawn By: skk
Aug 01 2008

DRESSER-RAND Wellsville Operations
Wellsville, NY 14895 USA

C-33306-3

CORRECTION FACTOR (CF)

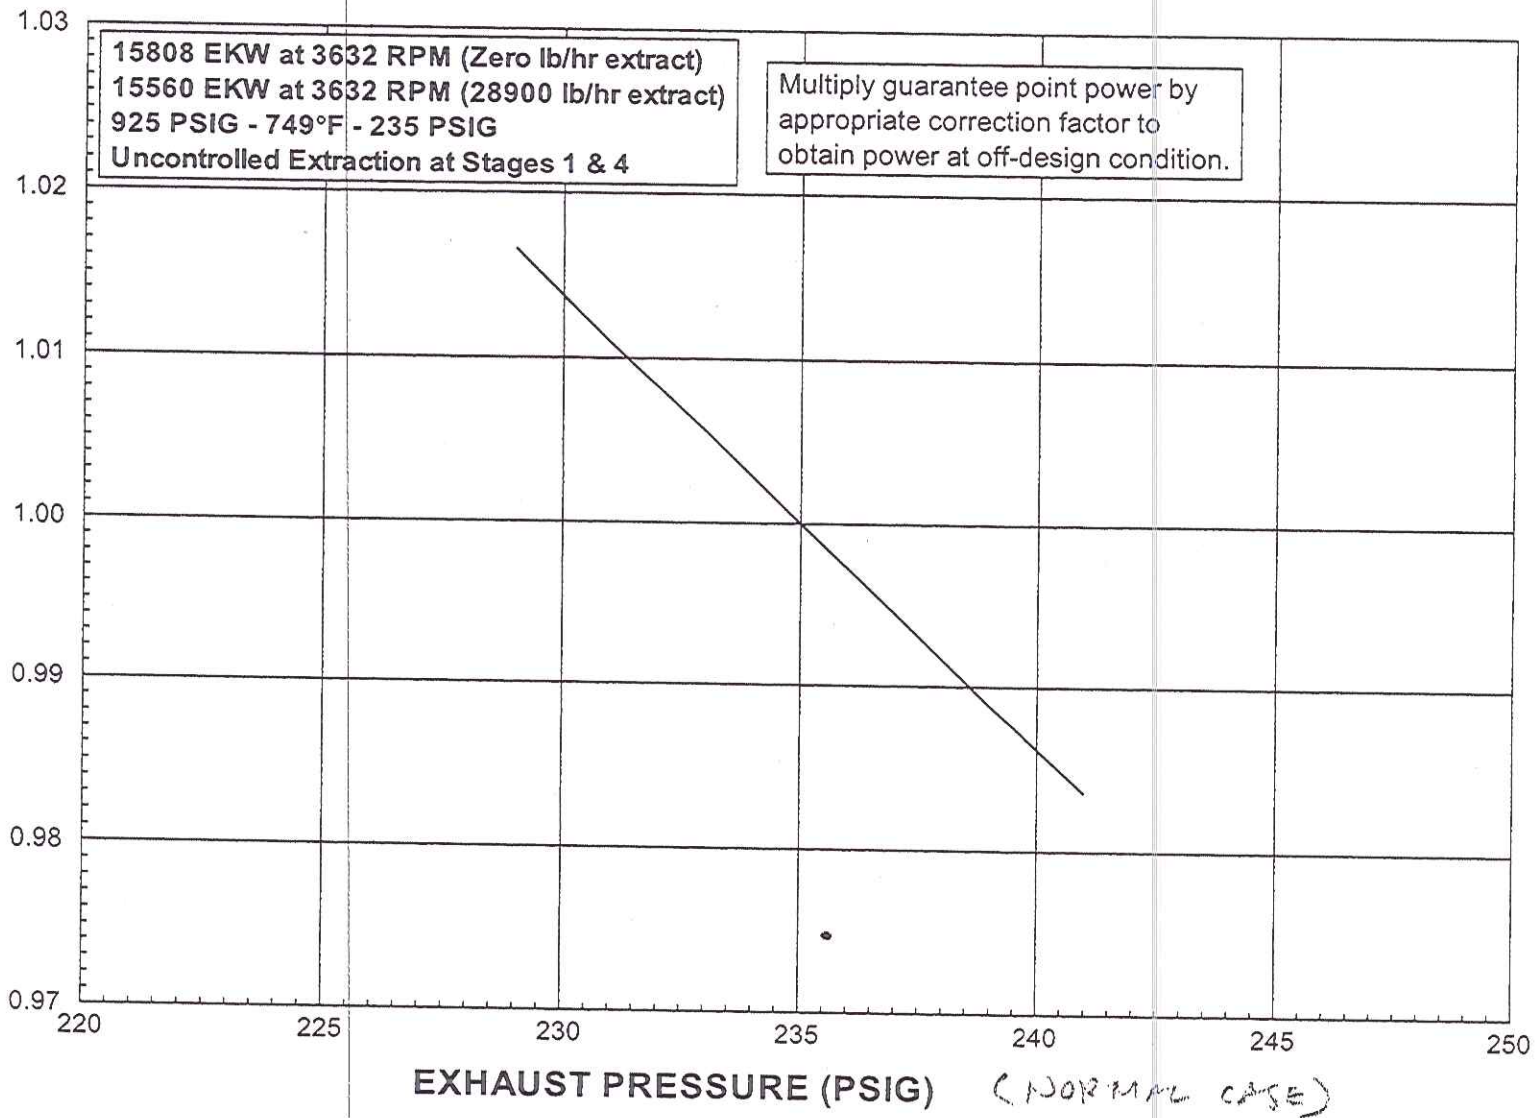


Drawn By: skk
Aug 01 2008

DRESSER-RAND Wellsville Operations
Wellsville, NY 14895 USA

C-33306-5

Generator Total Losses (KW)

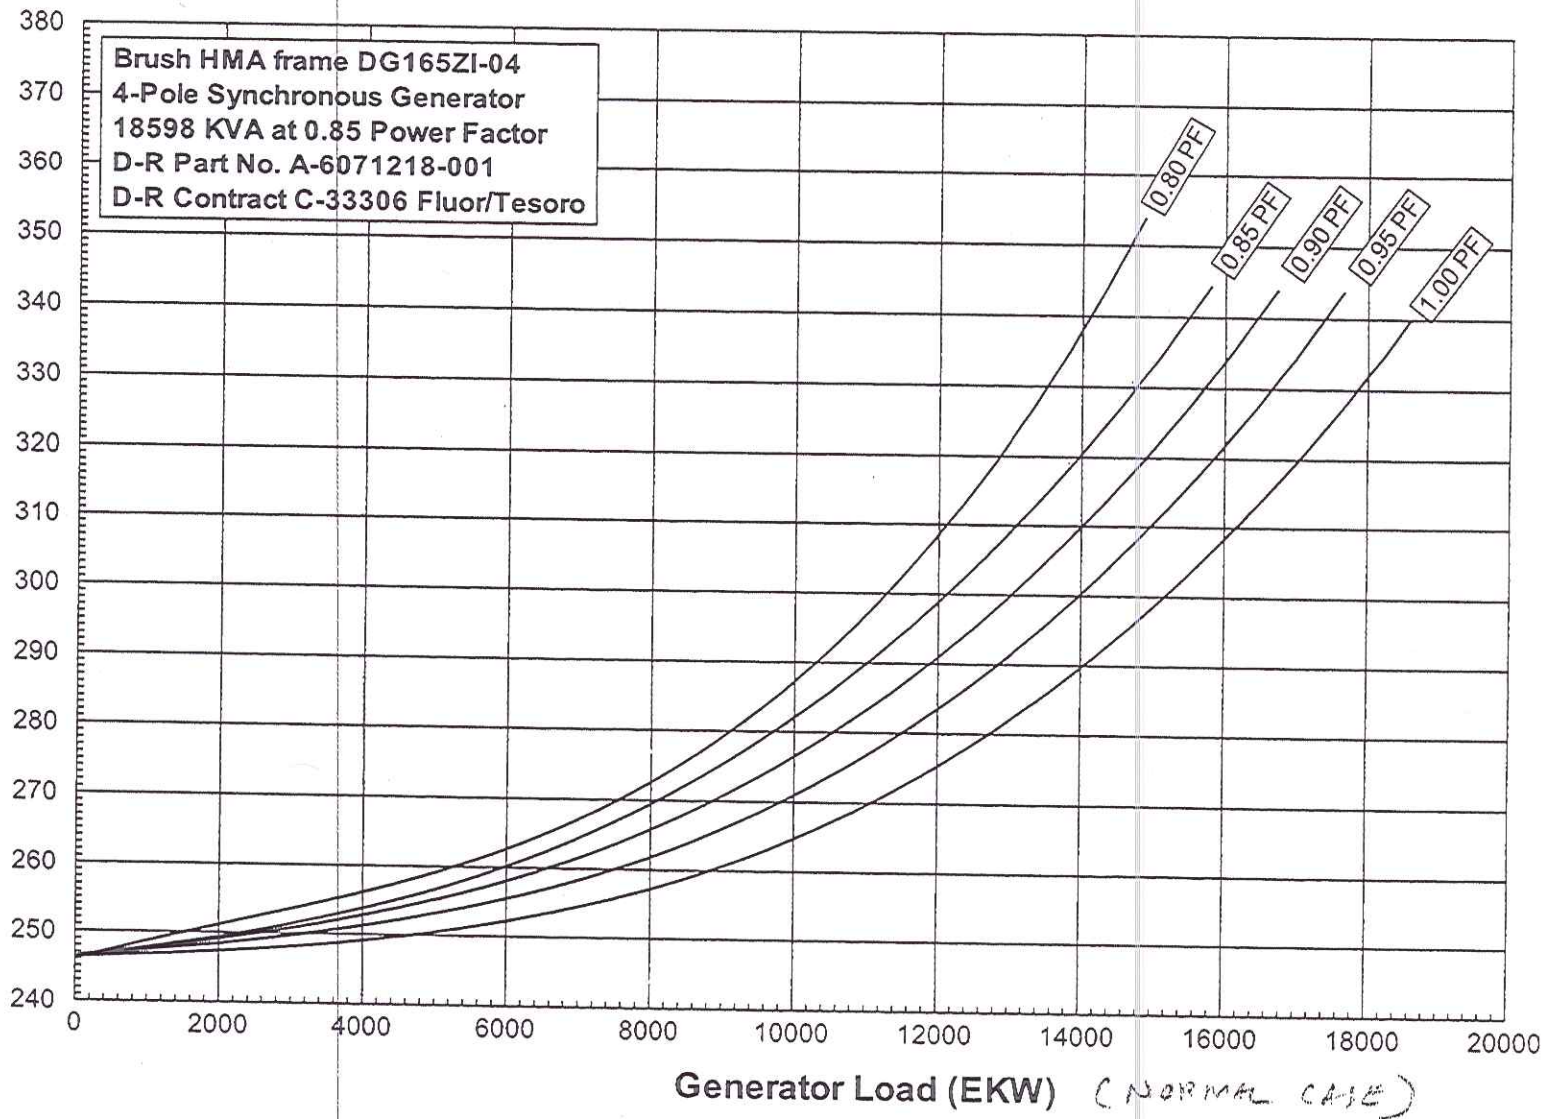

Drawn By: ets
Aug 25 2008

DRESSER-RAND

Wellsville Operations
Wellsville, NY 14895 USA

C-33306-6.iay

C-33306-6