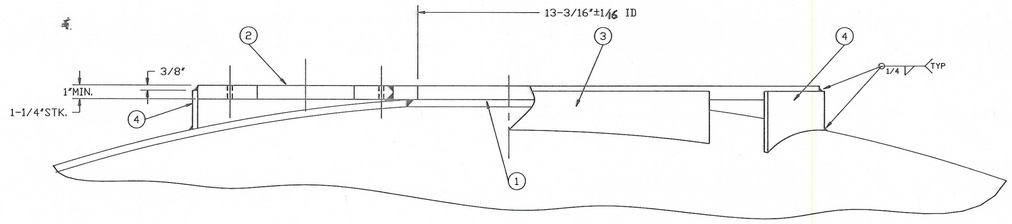

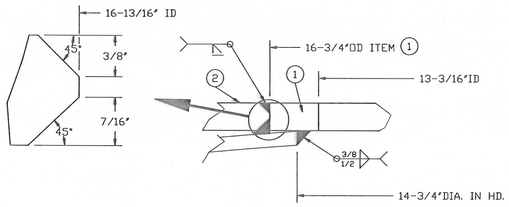

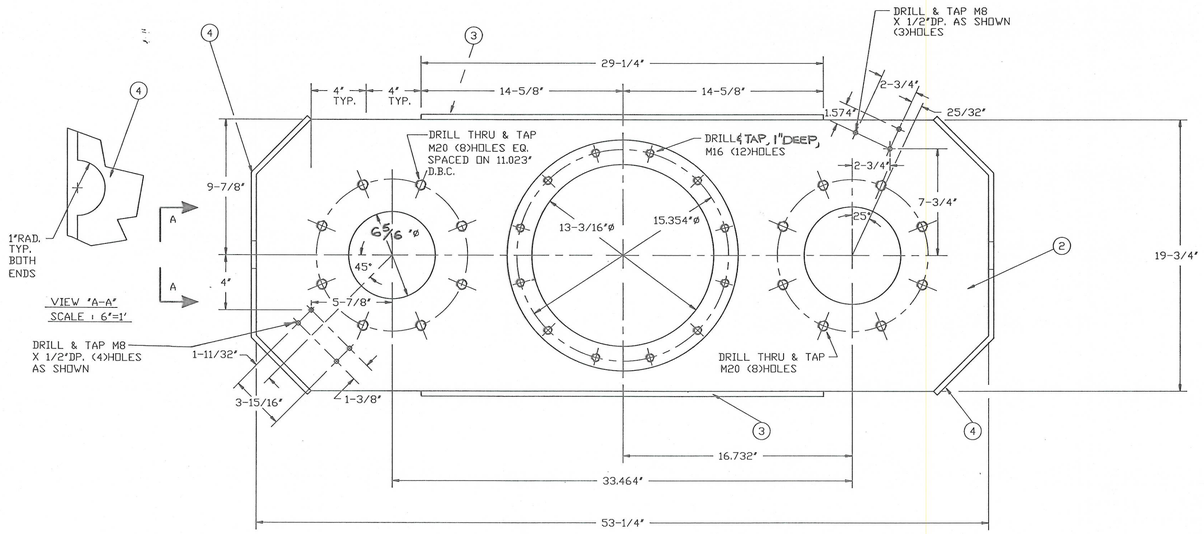

CAD REFERENCE NO.
RD00086A

ASME CODE

APPROVED DATE

CERTIFIED PRINT
Leon Robinson 7/26
Customer Order No.
Shop Order No.
GASTON COUNTY DYEING MACHINE CO.
Stanley, N. C.

ITEM NO.	QTY.	DESCRIPTION	MATERIAL		G.C. PART NO.	DRAWING NO.	QTY./PER.
60							
59							
4	2	PLATE , 3/8"THK. X 5-1/2" X 23-1/4"LG.	SA-240	304	6555026		.0283
3	2	PLATE , 3/8"THK. X 4" X 29-1/4"LG.	SA-240	304	6555026		.0136
2	1	PLATE , 1-1/4"THK. X 19-3/4" X 53-1/4"LG.	SA-240	304	9120016		1
1	1	RING , 16-3/4" +1/64 -1/32 OD X 13-3/4" +1/64 ID X 1-1/4" THK.	SA-240	316L	9122111		1

BILL OF MATERIAL P/N 3600446

REV.	DESCRIPTION	DATE	BY	CHECKED	APPROVED
G					
F					
E					
D					
C					
B	CHG SIZE OF SUPPORT PLATE & LOC OF HOLES	7/26/90	GMT	RDM	
A	ADD CODE BLOCK & WELD SIZE	7/17/90	RDD	RDM	

This shop drawing is the property of Gaston County Dyeing Machine Company and is not to be reused without written permission.

GASTON COUNTY FABRICATION
A DIVISION OF GASTON COUNTY DYEING MACHINE COMPANY
STANLEY, NORTH CAROLINA 704 263-4765

CUSTOMER ROSENMUND INC. CHARLOTTE , N.C. SANDOZ

TITLE AGITATOR PLATE DETAIL , 6M2 ROSENMUND 316L C-870

CUSTOMER P.O. NO. 197 | CUSTOMER ITEM NO. SC-170

DRAWN BY | DATE 05-27-94 | CHECKED BY RDM 7/26/90 | DATE

SHOP ORDER NO. F-80744 | NO. REQUIRED 1 | SHEET 1 OF 1

SCALE 3"=1" | No. E-3600446 | REV. B