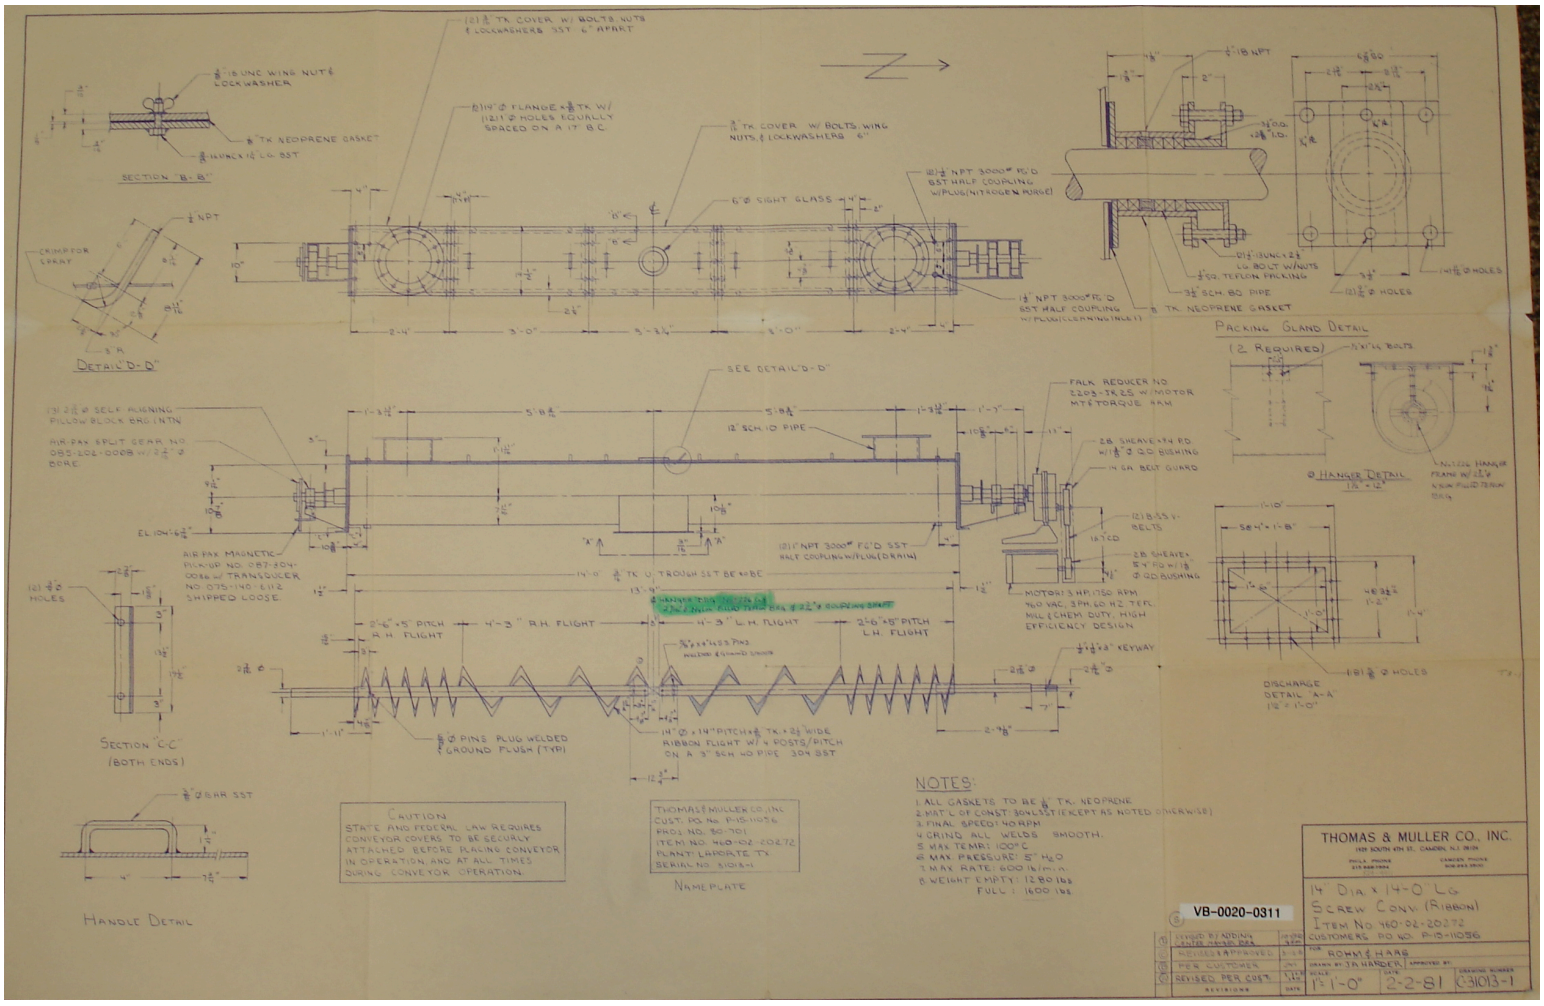
SECTION "B-B"
DETAIL "D-D"
SECTION "C-C" (BOTH ENDS)
HANDLE DETAIL
PACKING GLAND DETAIL
(2 REQUIRED)
HANGER DETAIL
DISCHARGE DETAIL A-A
CAUTION
STATE AND FEDERAL LAW REQUIRES CONVEYOR COVERS TO BE SECURELY ATTACHED BEFORE PLACING CONVEYOR IN OPERATION, AND AT ALL TIMES DURING CONVEYOR OPERATION.
NAMEPLATE
NOTES:
1. ALL GASKETS TO BE 1/8" TK. NEOPRENE
2. MAT'L OF CONST: 304L SST (EXCEPT AS NOTED OTHERWISE)
3. FINAL SPEED: 40 RPM
4. GRIND ALL WELDS SMOOTH.
5. MAX TEMP: 100°F.
6. MAX PRESSURE: 5" H2O
7. MAX RATE: 600 lb/min.
8. WEIGHT EMPTY: 1280 lbs
FULL: 1600 lbs
THOMAS & MULLER CO., INC.
14 DIA x 14'-0" LG.
SCREW CONV. (RIBBON)
ITEM NO. 460-02-20272
CUSTOMER'S PO NO. P-15-11096
VB-0020-0311
ROHM & HAAS
DRAWN BY: JA HARDER
SCALE: 1"=1'-0"
DATE: 2-2-81
DRAWING NUMBER: C-31013-1