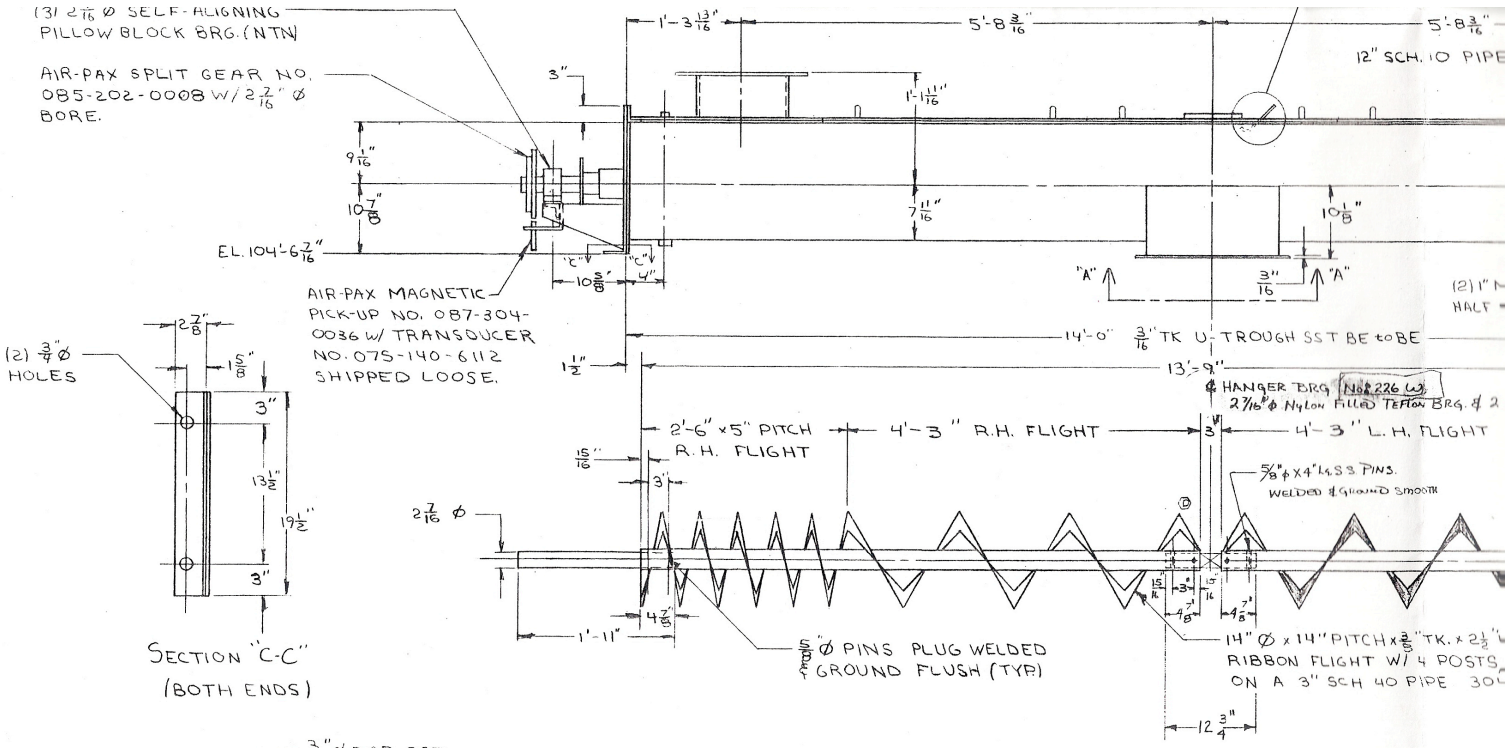

CAUTION

STATE AND FEDERAL LAW REQUIRES CONVEYOR COVERS TO BE SECURLY ATTACHED BEFORE PLACING CONVEYOR IN OPERATION, AND AT ALL TIMES DURING CONVEYOR OPERATION.

THOMAS & MULLER CO., INC.
CUST. PO. No. P-15-11056
PROJ. NO. 80-701
ITEM NO. 460-02-20272
PLANT: LAPORTE, TX.
SERIAL NO. 31013-1

NAME PLATE